REVISIONS	BY
3 AS BUILT 03.18.14	JEC
2 AS BUILT 6.02.14	DRS
1 AS BUILT 6.06.14	DRS

JOHN CARUSONE, ARCHITECT P.C.
31-87 30TH STREET, LONG ISLAND CITY, NEW YORK 11106 PHONE: (718) 545-8822-8823 - FAX (718) 956-1429

PROJECT:
FIRE DAMAGE RESTORATION OF IHOP, NEW C.O.
AND PUBLIC ASSEMBLY@ 73-01 NORTHERN BLVD.
JACKSON HEIGHTS, QUEENS, NY 11372

DRAWING TITLE:
FIRST FLOOR PLAN
SECOND FLOOR PLAN

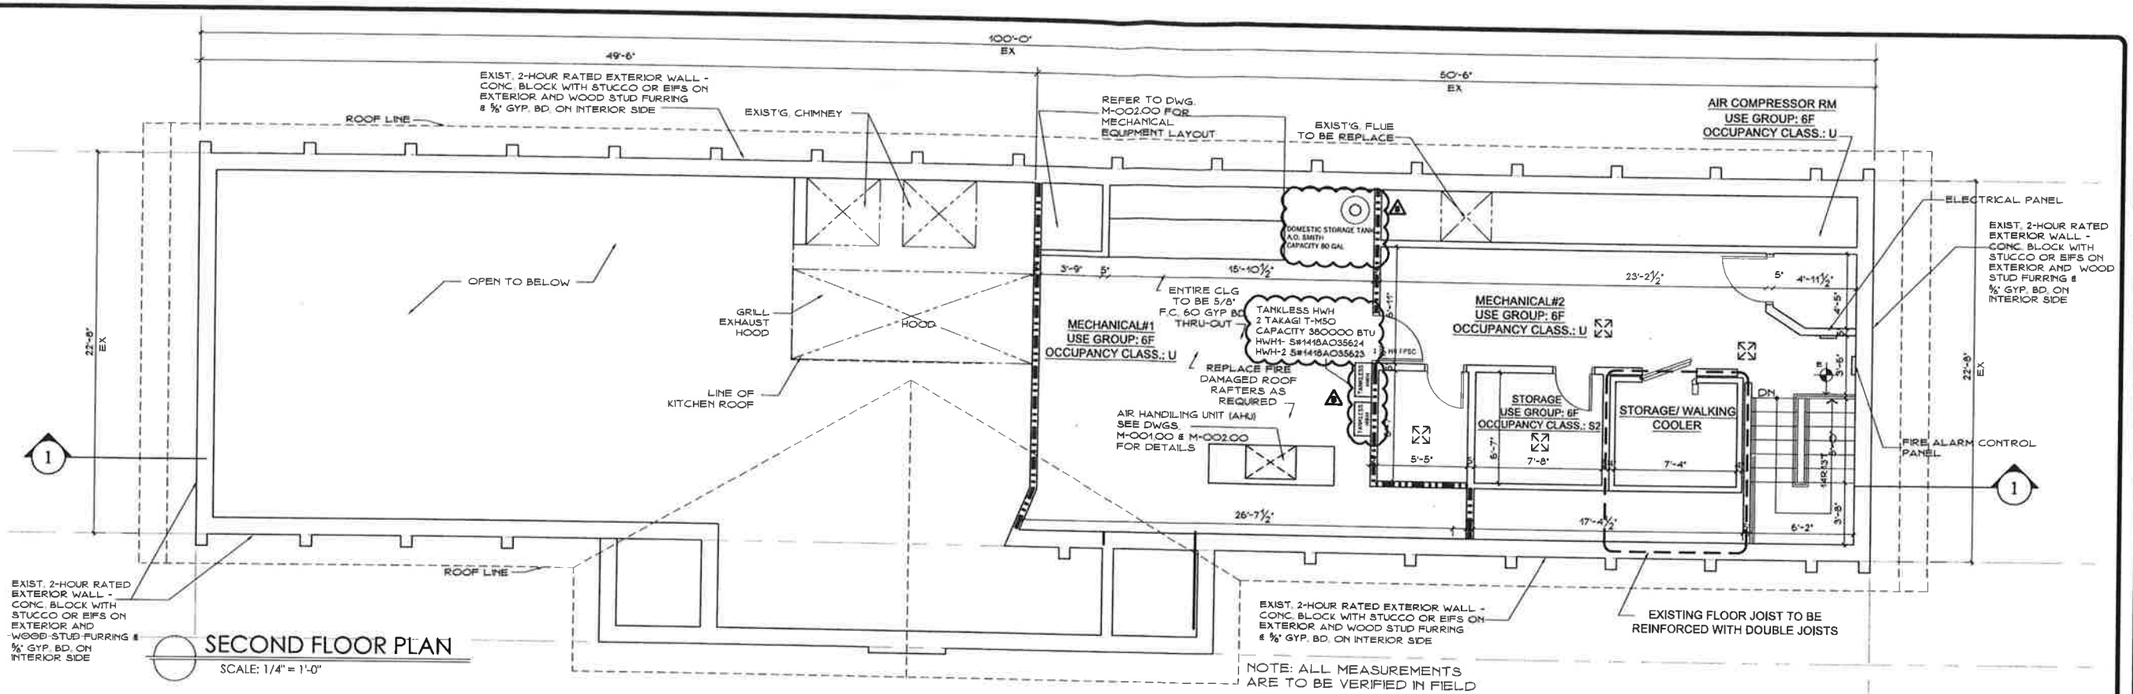

FIRST FLOOR OCCUPANCY: (SEE CALC. PA-001)

DINING AREA	= 82 PERSONS
EMPLOYEES	= 12 PERSONS
TOTAL	= 94 PERSONS ACT.

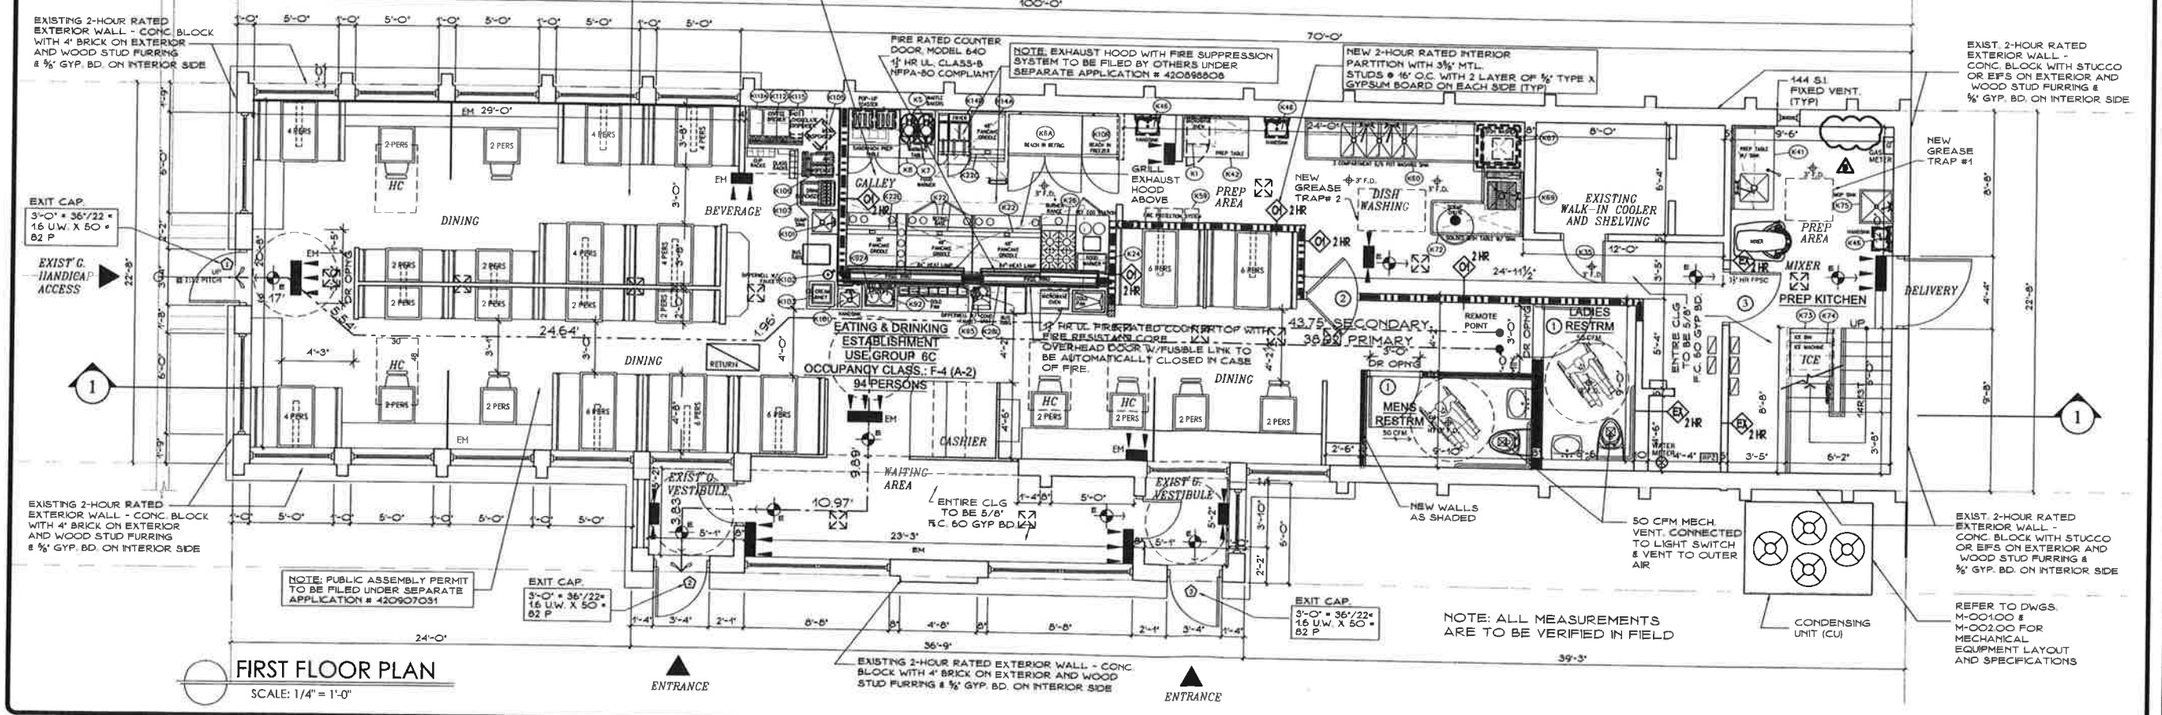

PROJECT:
ALTERATION-I
NORTHERN BLVD.

TITLE/FLOORS:
1ST FLOOR PLAN
2ND FLOOR PLAN

SEAL & SIGNATURE:

DATE: 10-07-13
PROJECT No: 13-113
DRAWN BY: IB
CHECKED BY: JC
DWG No.: A-100.03
CADD FILE No:
DWG No: 4 OF 9
B-SCAN JOB STICKER: